



AS-BUILT  
 DTP -  
 ATP - 62  
 JD - 20  
 JE - 2027

AS BUILT DRAWING

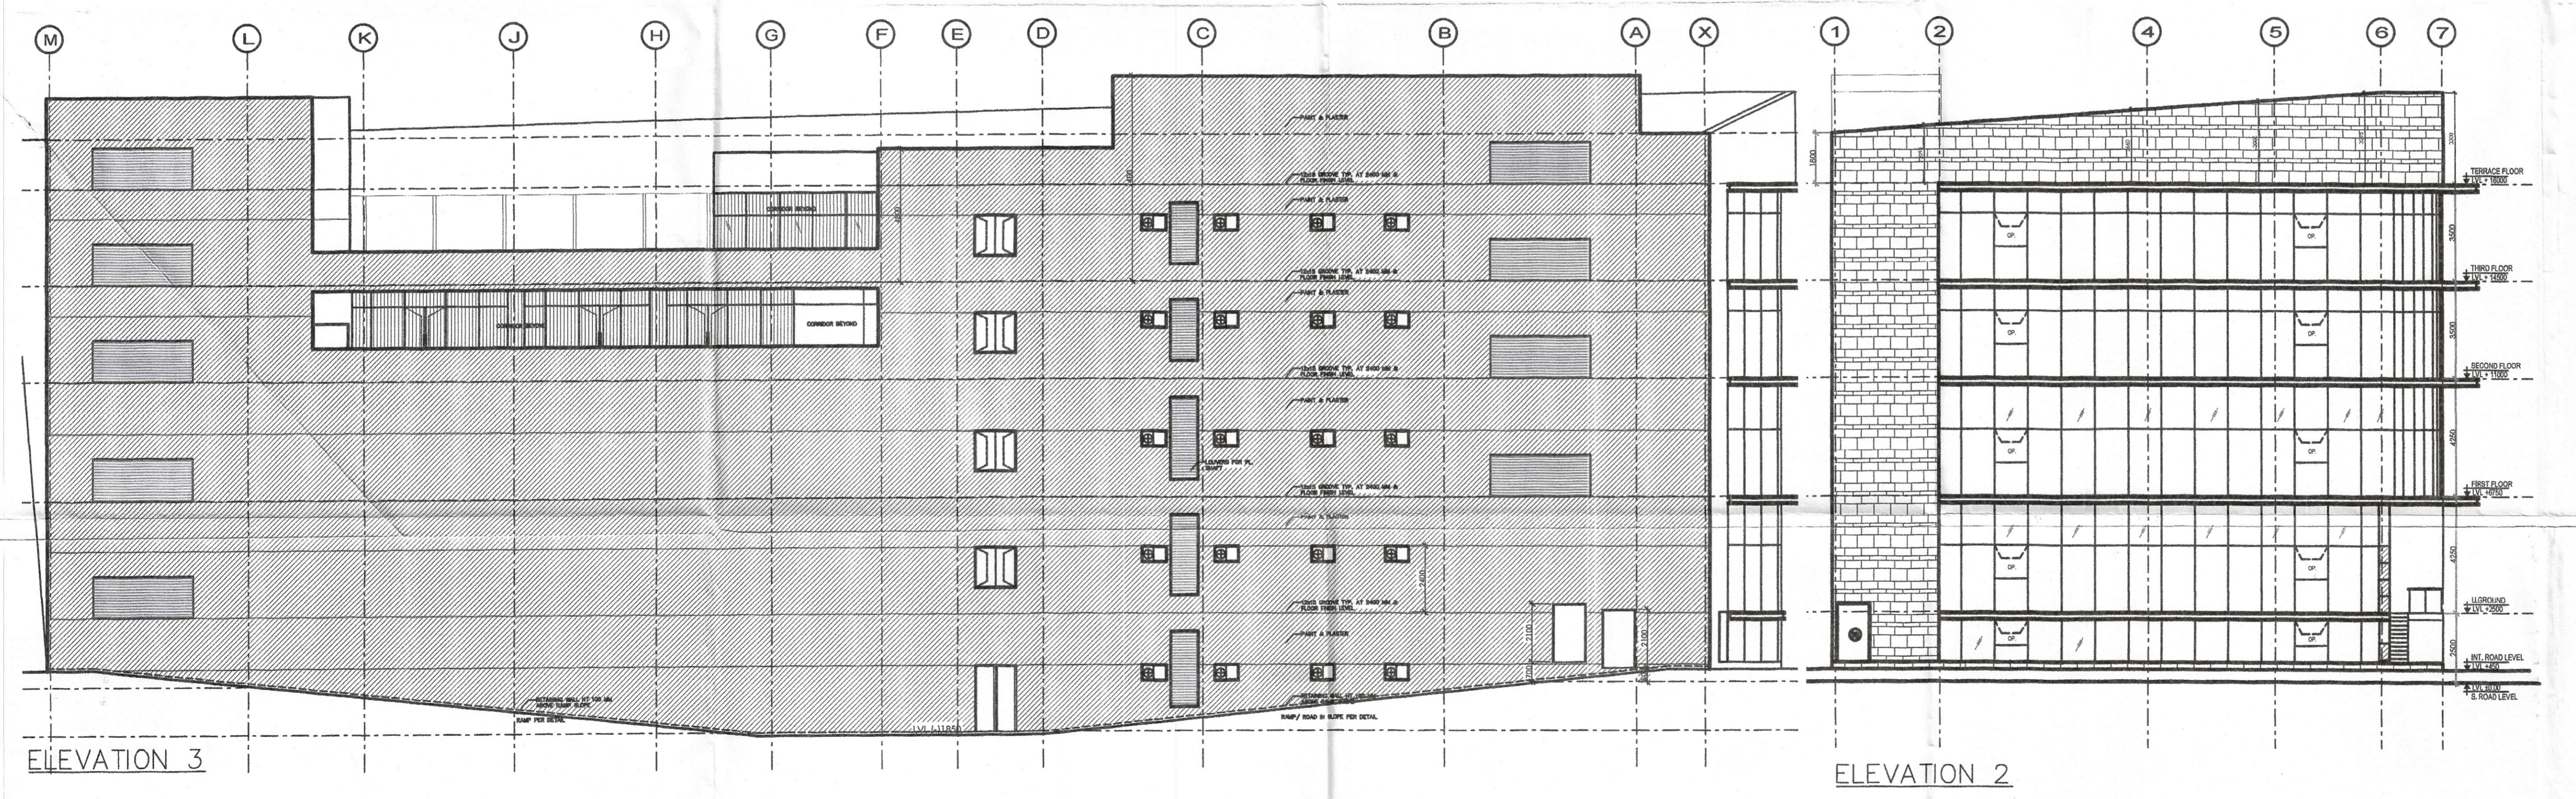

LANDSCAPE			
SERVICES			
STRUCTURAL			
OWNER	T. S. REALTECH PVT.LTD.		
PROJECT	IRIS BROADWAYGURGAON		
ARCHITECT	 <b>SIKKA ASSOCIATES ARCHITECTS</b> ARCHITECTS   INTERIORS   LANDSCAPE ARCHITECTS   ENGINEERING   PROJECT MANAGEMENT 4th FLOOR, ANAND BUILDING, SECTOR 14, GURGAON, HARYANA, INDIA   TEL: 011-26101111 2nd FLOOR, ANAND BUILDING, SECTOR 14, GURGAON, HARYANA, INDIA   TEL: 011-26101111 WWW.SIKKAASSOCIATES.COM		
REAL	ISSUED FOR INFO. & REVIEW		
	TENDER		
	SUBMISSION		
	G.C.		
	AS BUILT		
REVISIONS - NEW REVISIONS PER SERVICES DRAWINGS			
Sl. No.	DATE	DESCRIPTION	ISSUED TO
SCALE	1:100	REVISION:	
DATE ISSUED	2019 03 12	RO	
DRAWN BY	KUNJAR	FIGURE:	
CHECKED BY	SAURABH		
PLOT B			
ELEVATIONS			
477		IB/PB/B/EL-01	