


DTP
 ATP
 AD
 JB

ATP 6/1
 JD
 JE - Noor

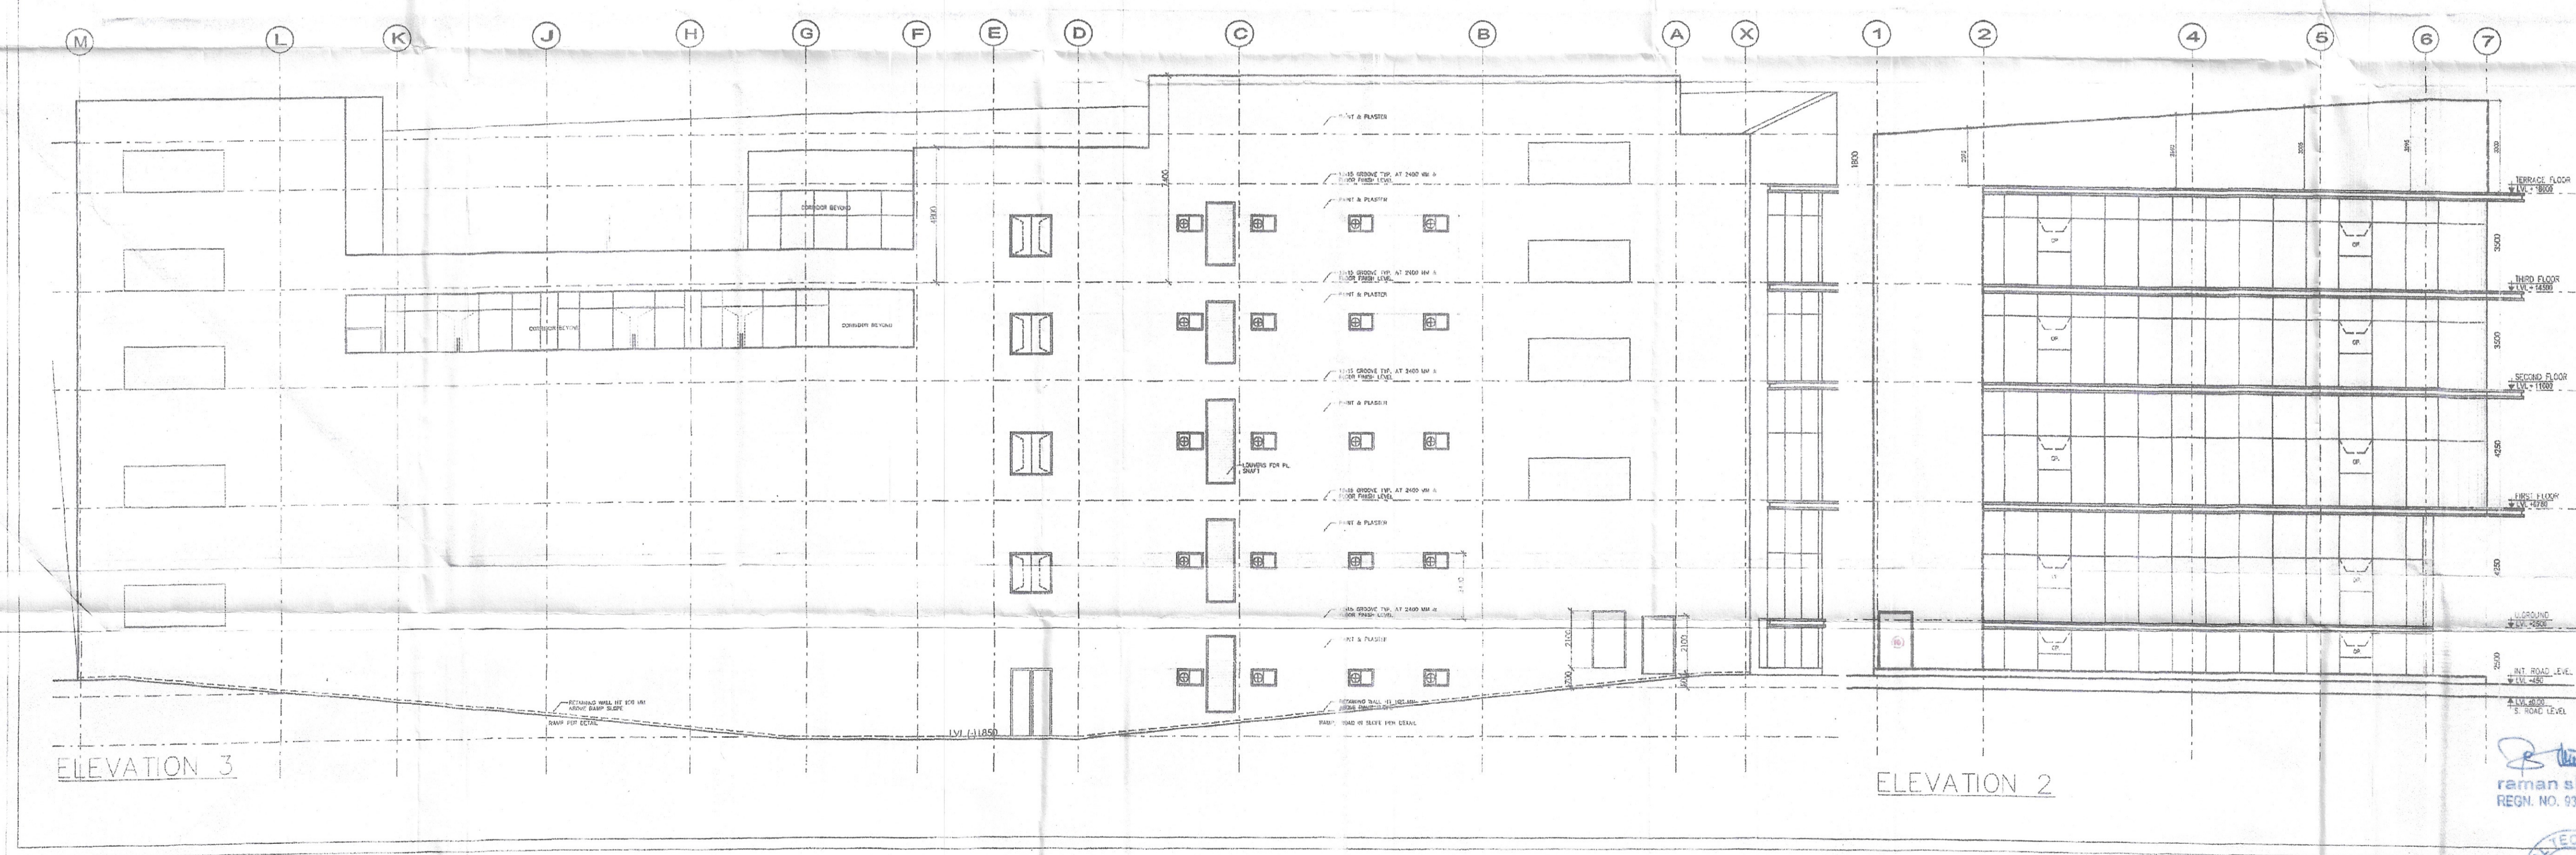

AS BUILT DRAWING

NNC DESIGN INTERNATIONAL
 CONSULTING STRUCTURAL ENGINEERS
 C-70, 2ND FLOOR, AIRPORT ROAD, NEW DELHI-110065
 PHONE NO. +91-11-2619747/8 FAX NO. 2619749
 E-Mail : nnc_consulting@yahoo.com
 Web : www.nncdesigninternational.com

SAA
SIKKA ASSOCIATES ARCHITECTS
 4-2/A, AFRIKA AVENUE, SHYAMLAPUR ENCLAVE, NEW DELHI-110028
 TEL. NO. +91-11-2619747/8 FAX NO. 2619749
 www.sikka.com

ISSUED FOR
 INFO & REVIEW
 CHECKED
 SUBMITTED
 GFC
 AS BUILT

REVISIONS - NEW REVISIONS PER SERVICES DRAWING

SCALE 1:100

DATE ISSUED 21/10/05

DRAWN BY KUNALI

CHECKED BY SAURASH

PLOT B
 ELEVATIONS

477 IB/PB/B/EL-01

raman sikka
 REGD. NO. 9316497

RED COLOR SHOWING DEVIATION FROM SANCTIONED PLANS

DEVIATION DRAWING