
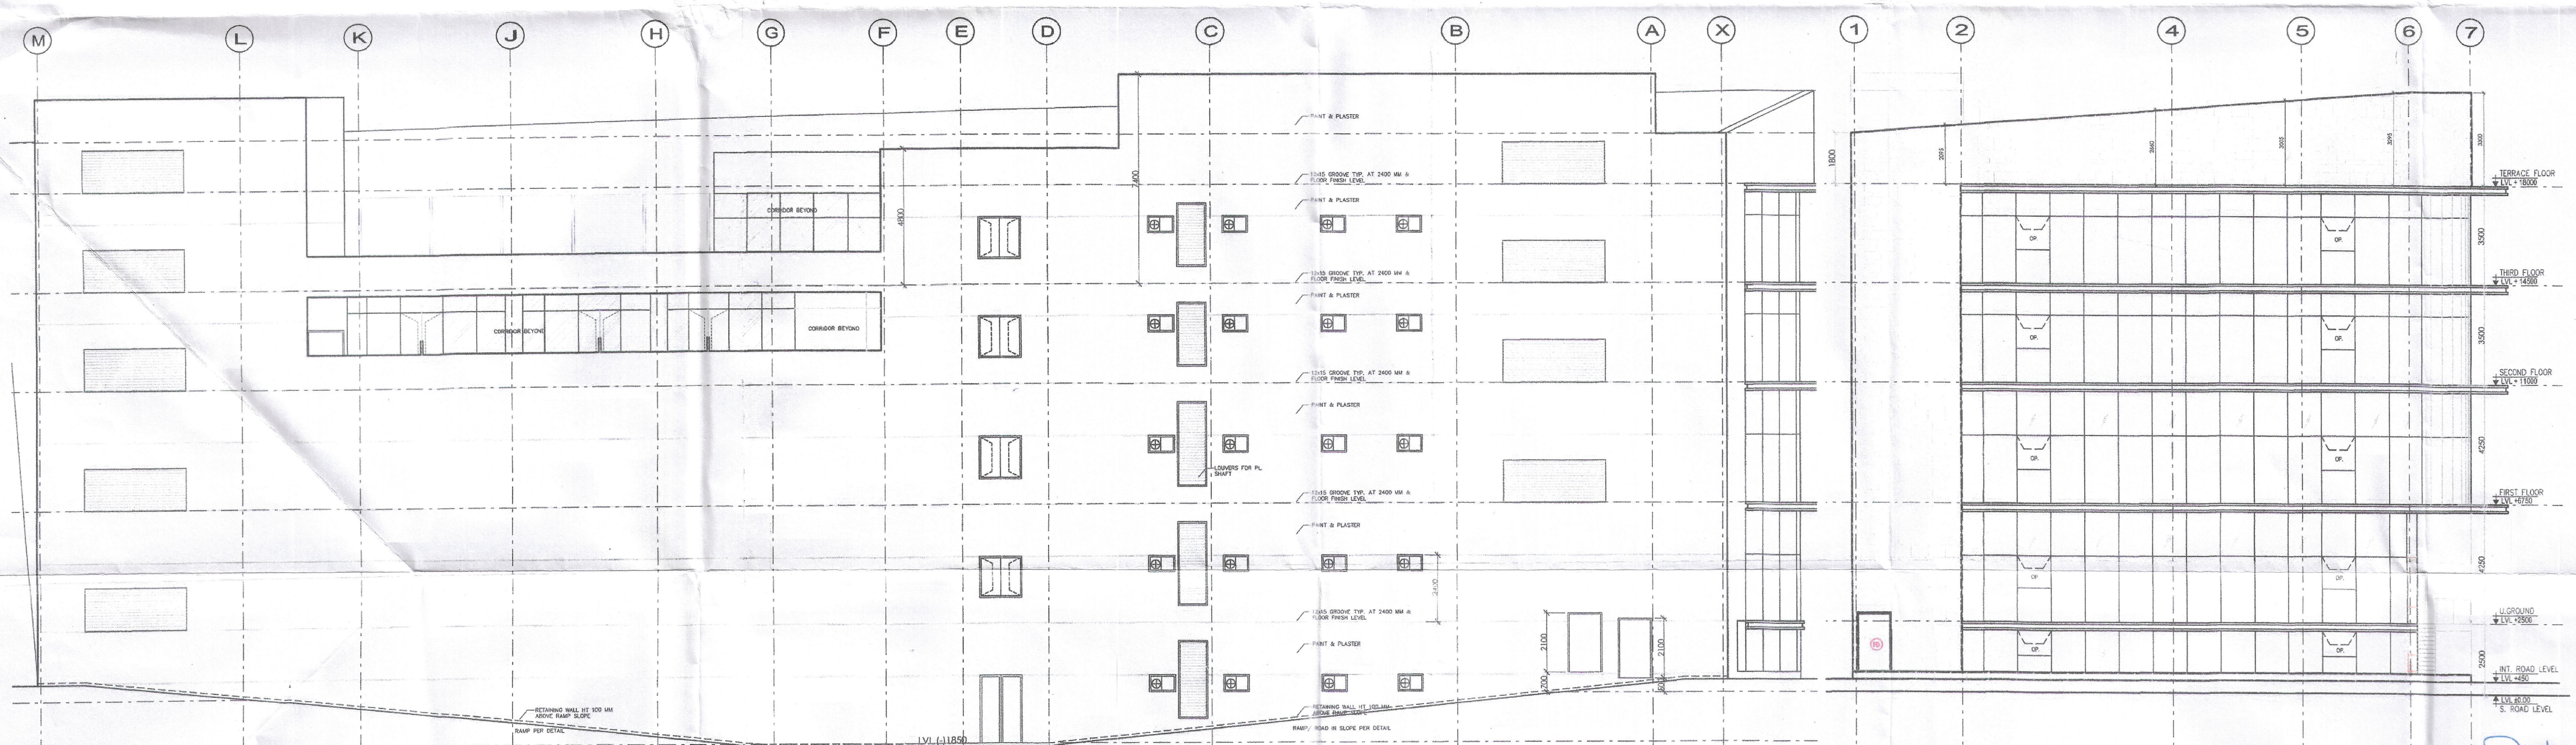


DTP
ATP
AD
JB

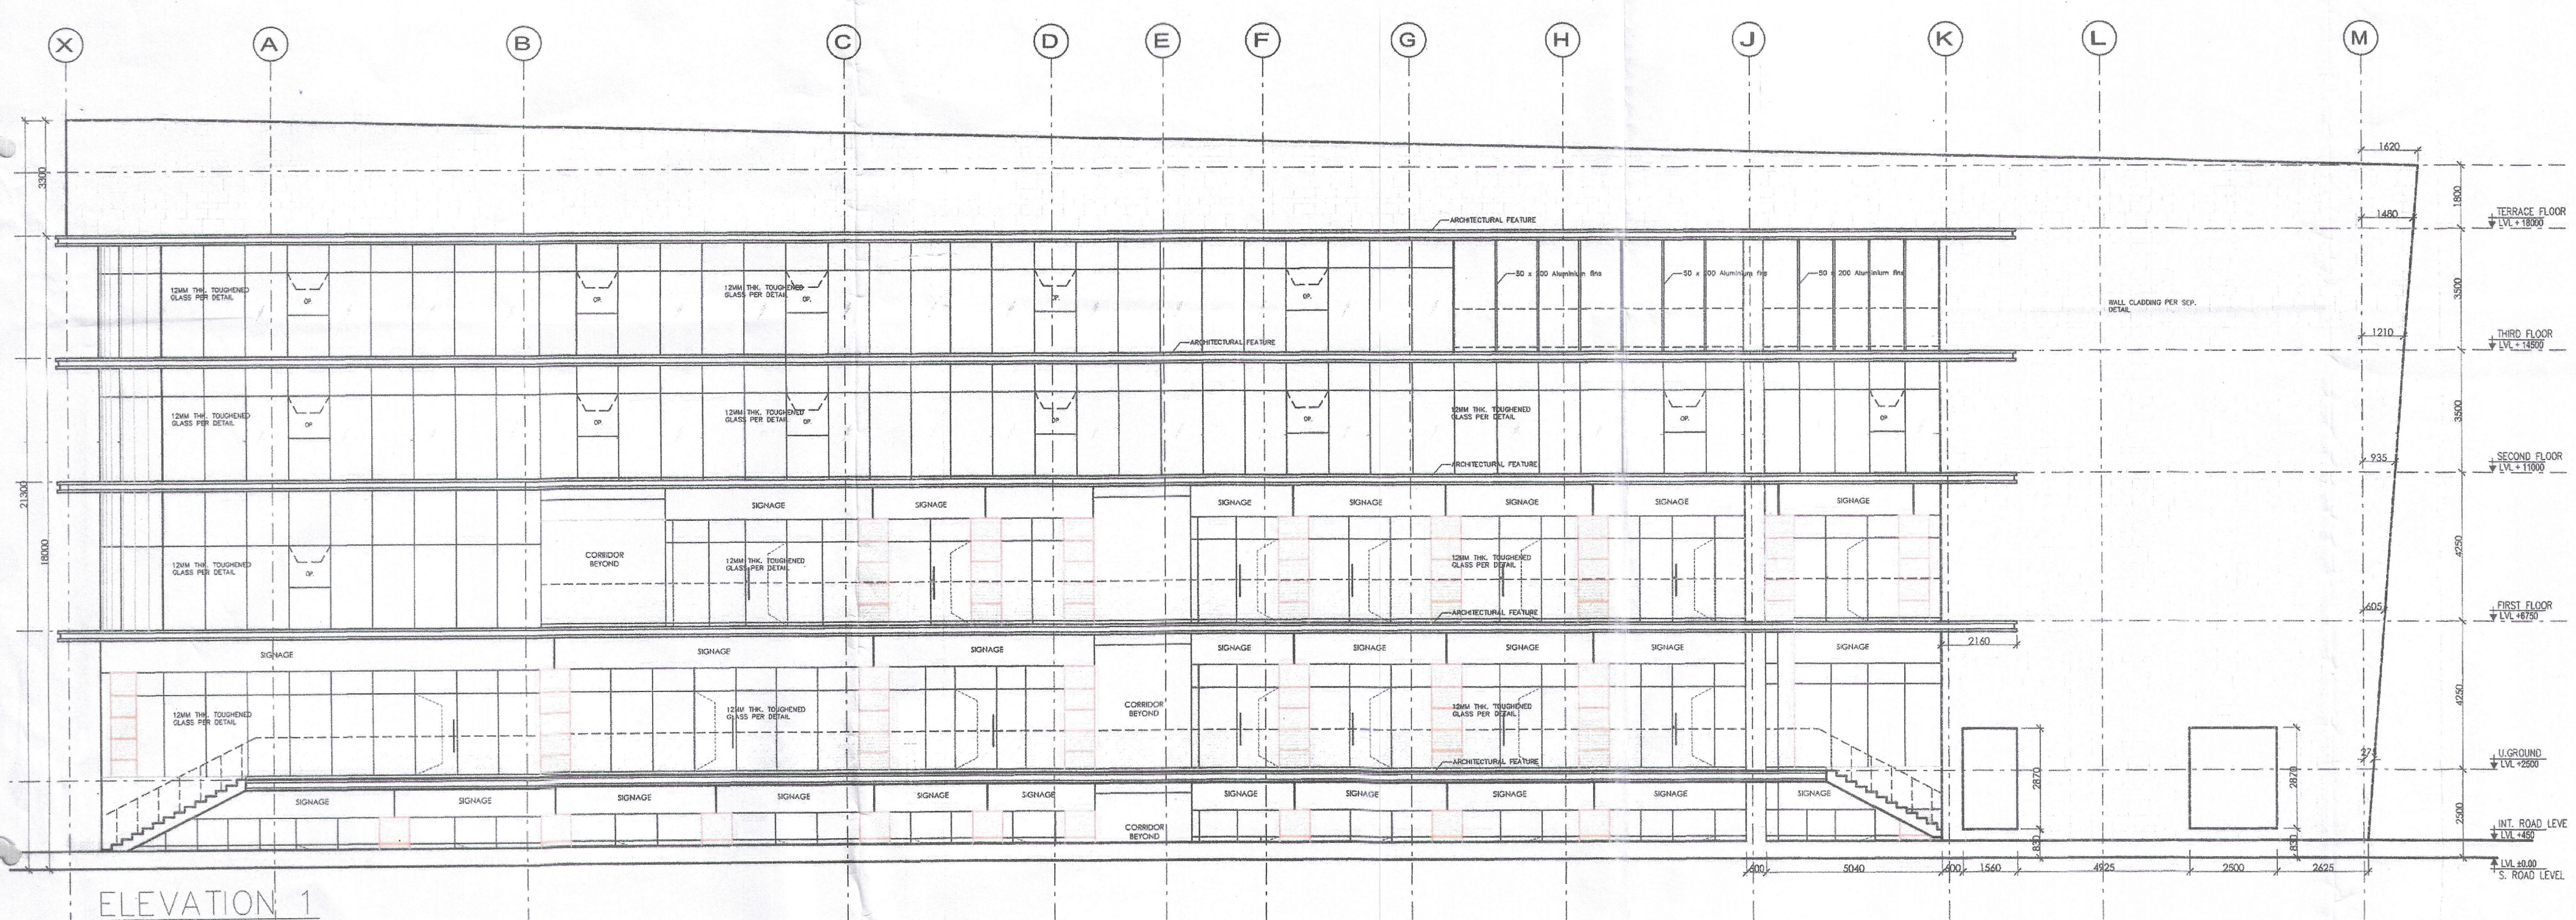

AS BUILT DRAWING

LANDSCAPE	
SERVICES	
STRUCTURAL	NNC DESIGN INTERNATIONAL CONSULTING STRUCTURAL ENGINEERS G-70, THE PLAZA, ROYAL PLAZA, NEAR KALINGA STADIUM MAIN MARKET, TILAK ROAD, GURGAON, NEW DELHI-110006 PHONE NO. +91-11-2946794/75/76 FAX: 2946720 E-MAIL: nncdesigninternational@gmail.com Web: www.nncdesigninternational.com
OWNER	T. S. REALTECH PVT. LTD.
PROJECT	IRIS BROADWAY, GURGAON
ARCHITECT	SAA SIKKA ASSOCIATES ARCHITECTS SIKKA ASSOCIATES ARCHITECTS ARCHITECTURE INTERIORS ENGINEERING PROJECTS B-2/1, AFRA AVENUE, SARVAPALLI ENCLAVE, NEW DELHI, INDIA-110023 P: +91-11-43333333 F: +91-11-2623-4481 E: saasika@gmail.com www.saasika.com
SEAL	ISSUED FOR INFO & REVIEW TENDER SUBMISSION GFC AS BUILT
REVISIONS	NEW REVISIONS PER SERVICES DRAWING
SCALE	1:100
DATE ISSUED	2019.03.12
DRAWN BY	KUMAR
CHECKED BY	SAURABH
PROJECT NO.	477
REVISION NO.	IB/PB/B/EL-01

remam sikka
REGN. NO. 93161497

