

FIRST FLOOR

DTP
ATP
AD
JE

AS BUILT DRAWING

NOTES:-
1. ALL BUILDING EXCLUDING BASEMENTS CENTRALLY AIR CONDITIONED AND MECHANICALLY VENTILATED AS PER N.B.C. NORMS.
2. ALL BASEMENTS ARE MECHANICALLY LIGHTED AND VENTILATED AS PER N.B.C. NORMS.
3. ALL BUILDING INCLUDING BASEMENT FULLY SPRINKLERED AS PER N.B.C. NORMS.
4. EXTERNAL WALLS SHOULD NOT BE LESS THAN 230 MM.

KEY PLAN

PLOT B AS BUILT DRAWINGS

REVISED BUILDING PLANS FOR COMMERCIAL COLONY MEASURING 2.8 ACRES(LICENCE NO. 40 OF 2012 DATED 12/4/2012)IN SECTOR 85 & 86 GURGAON MANESAR URBAN COMPLEX BEING DEVELOPED BY T. S REALTECH PVT. LTD.

OWNER T.S. REALTECH PVT.LTD.

PROJECT IRIS BROADWAY GURGAON



REVISIONS	DESCRIPTION
#	DATE

REVISIONS	DESCRIPTION
#	DATE

SCALE 1:150 @ A1 (SHEET SIZE)

DATE ISSUED 2019 03 04

DRAWN BY KUMAR


CHECKED BY

DRAWING FLOOR PLANS PLOT B

DWG NO. 477/IB/B/01

DOOR-WINDOW SCHEDULE

TYPE	SIZE	QILL	LINTEL	LOCATION
D1	1600 X 2100	00	2100	TOILETS
D2	1200 X 2100	00	2100	HC TOILET / SHOPS
D3	1500 X 2100	00	2100	SHOPS
FD	1200 X 2100	00	2100	FIRE EXITS
FD1	1500 X 2100	00	2100	FIRE TOWER / LIFT LOBBY
W	1500 X 1200	1200	2400	LIFT LOBBY
W1	3750 X 1200	1200	2400	SHOPS
W2	1575 X 1200	1200	2400	SHOPS
W3	4525 X 1200	1200	2400	SHOPS
W4	6960 X 1200	1200	2400	SHOPS
W5	4000 X 1200	1200	2400	STAIRCASE
W6	1950 X 1200	1200	2400	STAIRCASE
W7	3300 X 1200	1200	2400	STAIRCASE
V	2100 X 1200	1200	2400	TOILETS
V1	1200 X 1200	1200	2400	HC TOILET
GL1	16340 X 1200	1200	2400	SHOPS
GL2	28485 X 1200	1200	2400	SHOPS
GL3	7545 X 1200	1200	2400	SHOPS
GL4	6165 X 1200	1200	2400	SHOPS
GL5	1680 X 1200	1200	2400	SHOPS
GL6	1625 X 1200	1200	2400	SHOPS
GL7	6030 X 1200	1200	2400	SHOPS
GL8	20835 X 1200	1200	2400	SHOPS
GL9	2660 X 1200	1200	2400	SHOPS
GL10	12685 X 1200	1200	2400	SHOPS
GL11	20175 X 1200	1200	2400	SHOPS
GL12	51800 X 1200	1200	2400	SHOPS
GL13	4360 X 1200	1200	2400	SHOPS
GL14	19520 X 1200	1200	2400	SHOPS
GL15	14320 X 1200	1200	2400	SHOPS
GL16	16545 X 1200	1200	2400	SHOPS
GL17	24215 X 1200	1200	2400	SHOPS
GL18	28230 X 1200	1200	2400	SHOPS
GL19	16845 X 1200	1200	2400	SHOPS
GL20	6475 X 1200	1200	2400	SHOPS
GL21	52885 X 1200	1200	2400	SHOPS

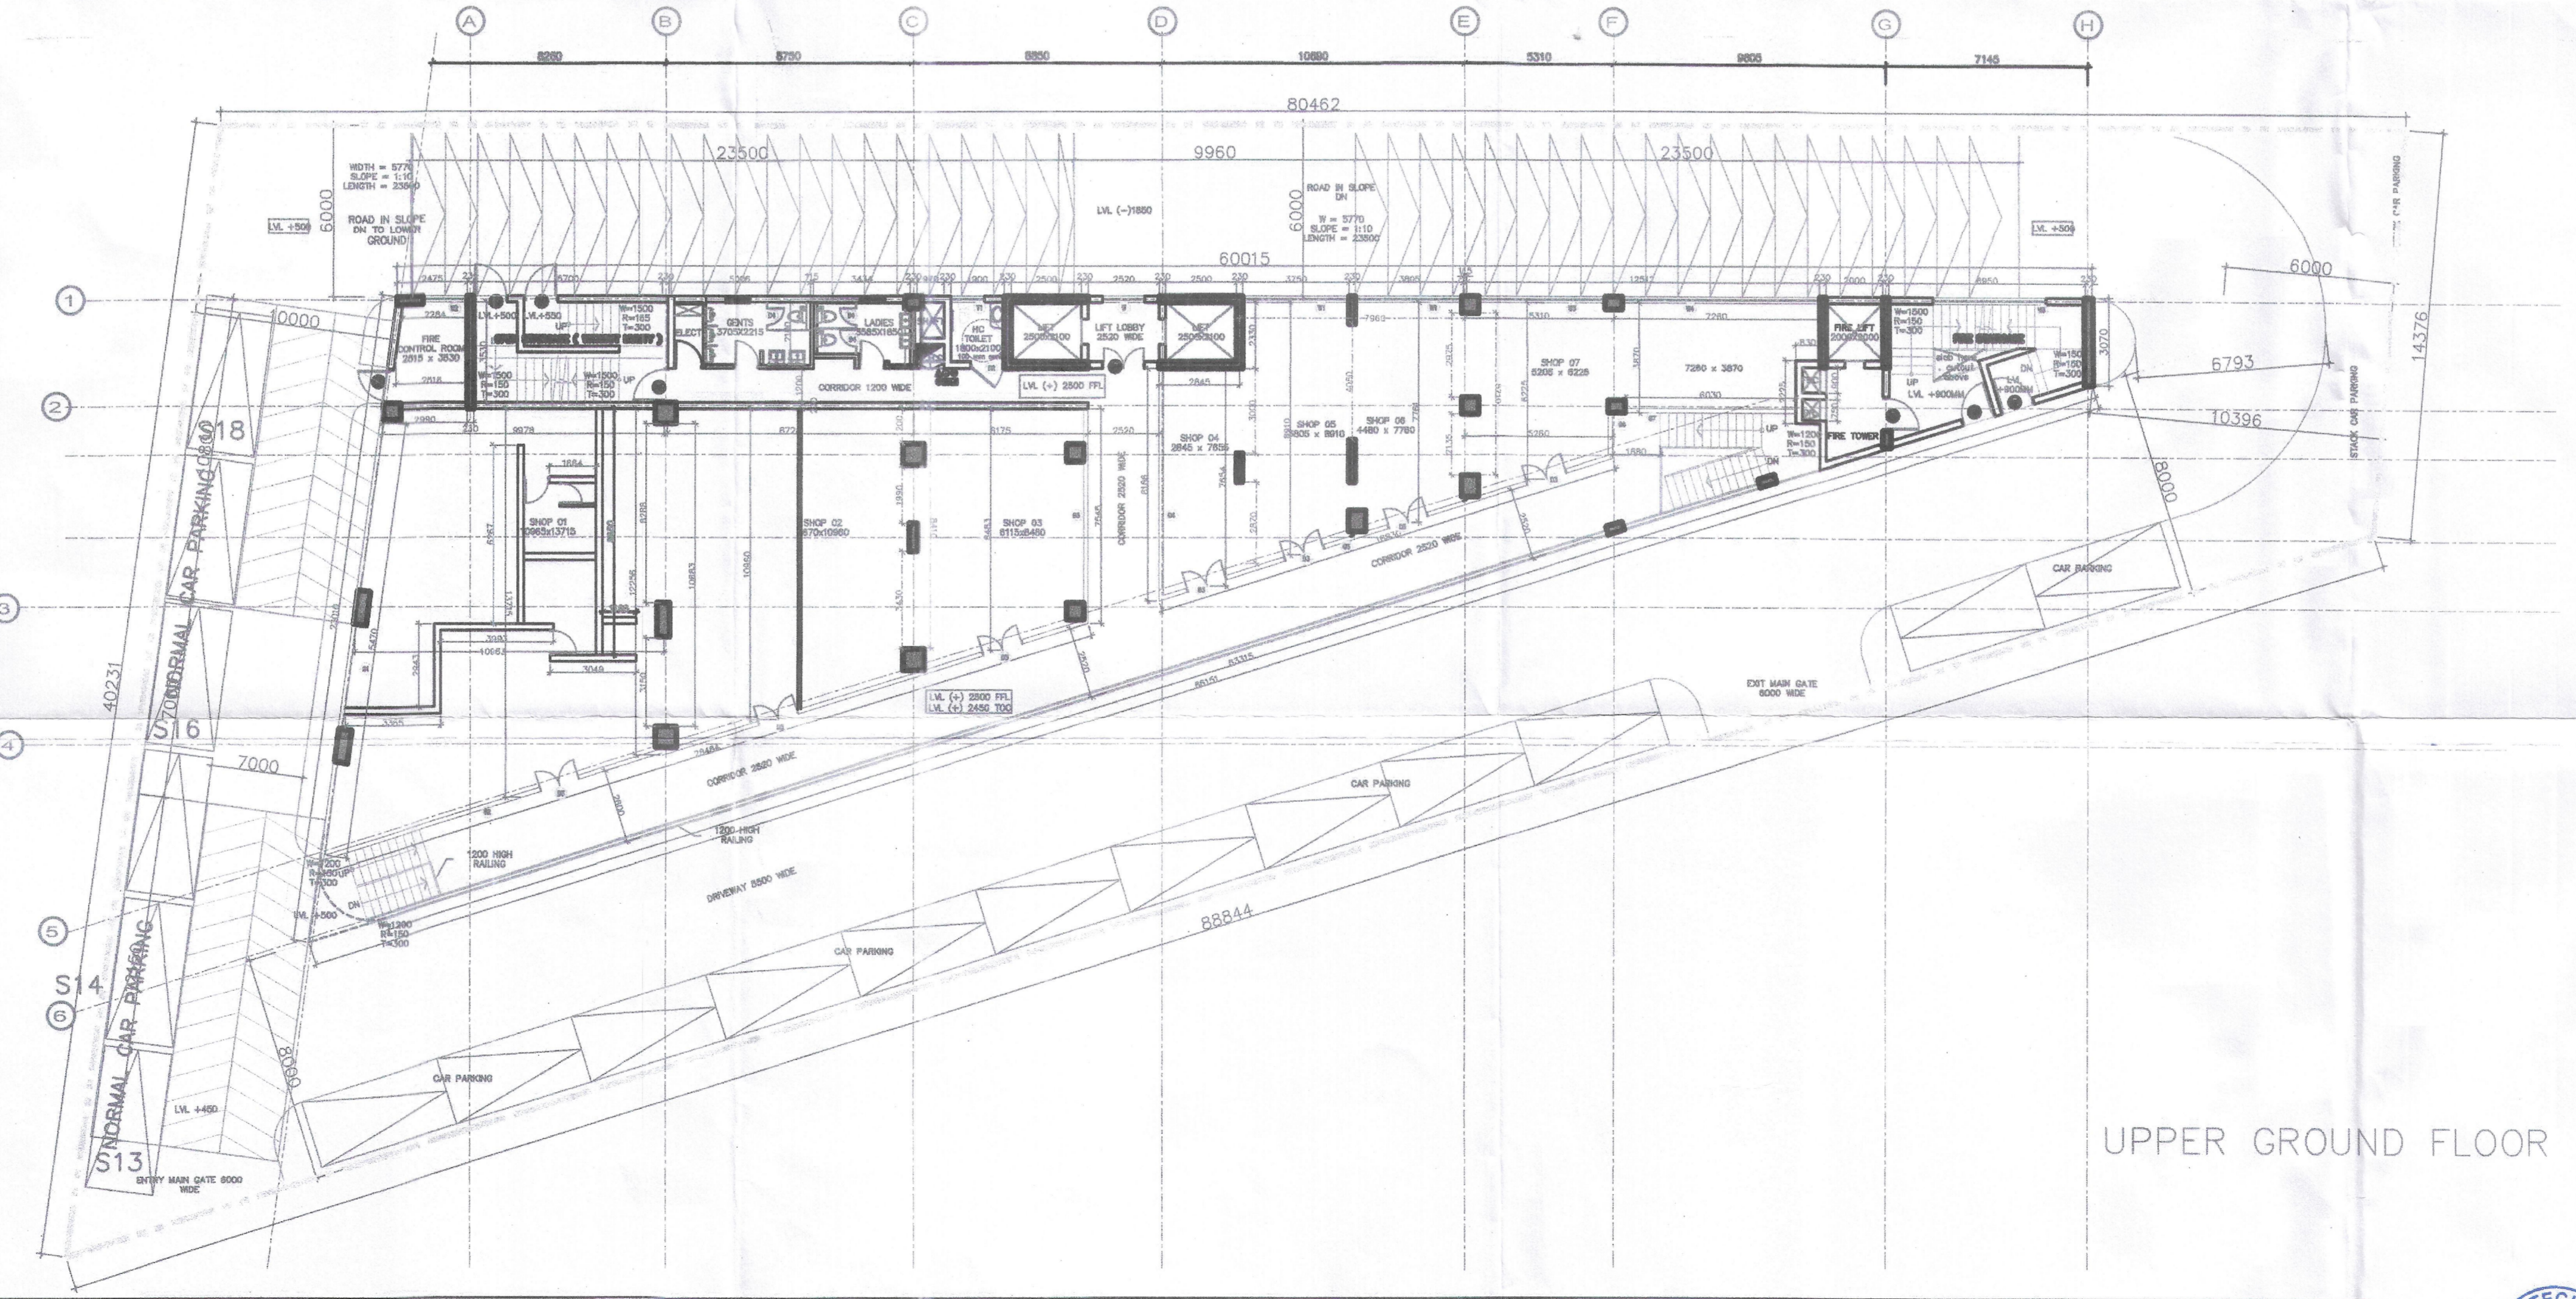

UPPER GROUND FLOOR

Stamp: T.S. REALTECH PVT. LTD. with signature and date.

Stamp: SIKKA ASSOCIATES ARCHITECTS with signature and registration number 'REGN. NO. 9316497'.